
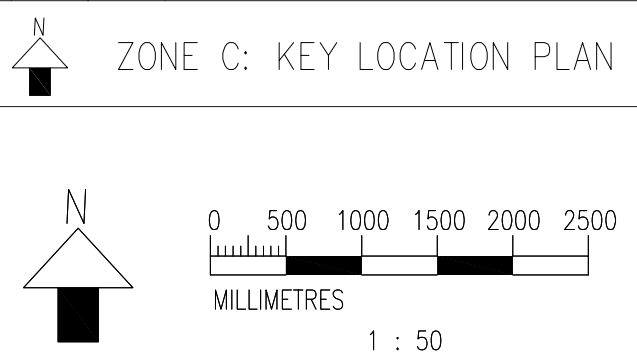
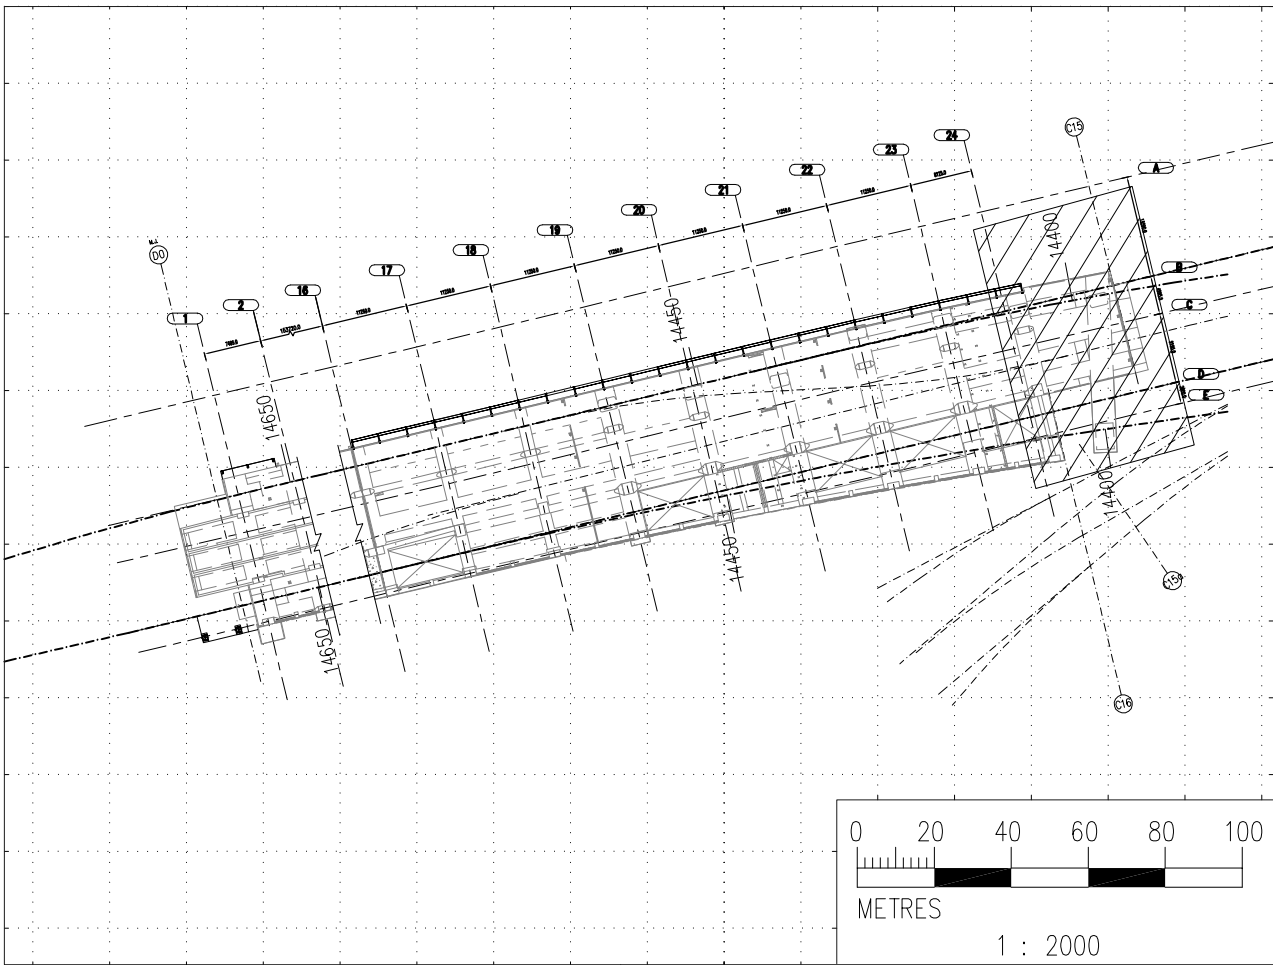


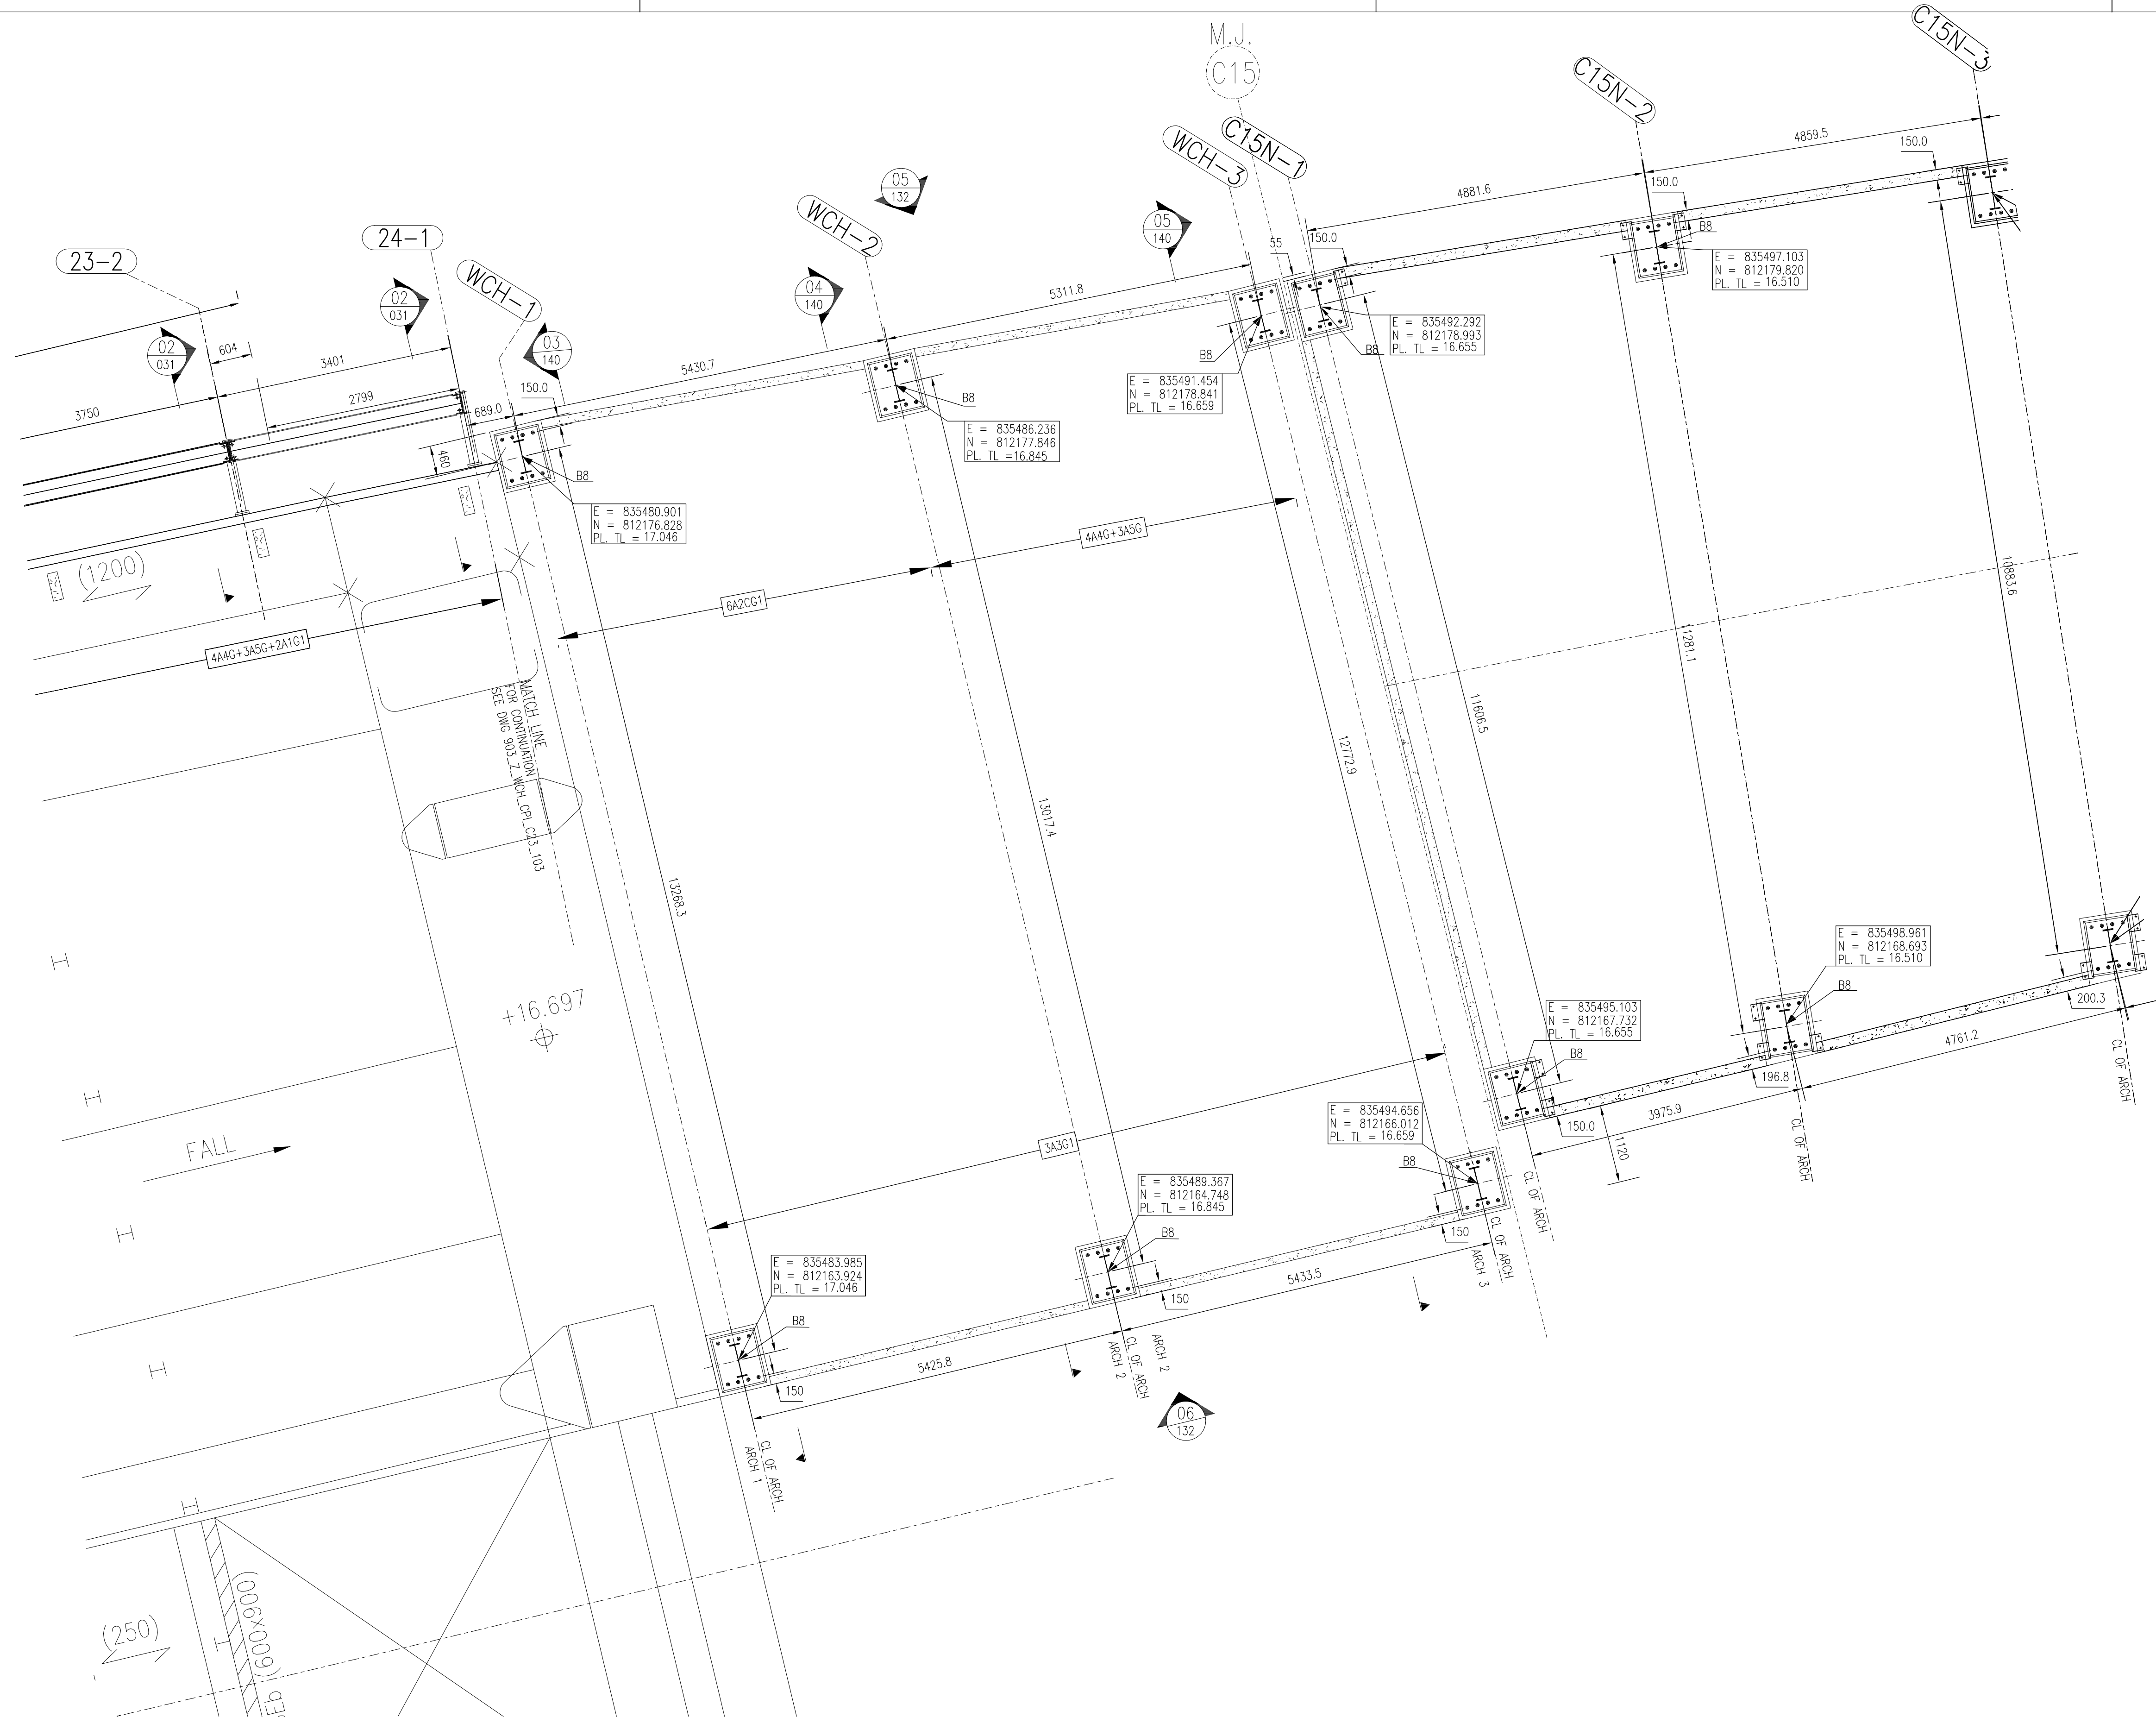

5 BASE PLATE LAYOUT
011 SCALE 1:50

MTR
APPROVED AS-BUILT DRAWING
Signed _____ Date _____

PRINTED BY:

PLOT DRW:
MODELNAME:
FILENAME:

																																																																																																																																																																																																																																																																																																																																																																																																																																																																																																																																																																																																																																																																																																																																																																																																																																																																																																																																																																																																																																																																																																																																																																																																																																																																																																																																																																																																																					</
--	--	----