



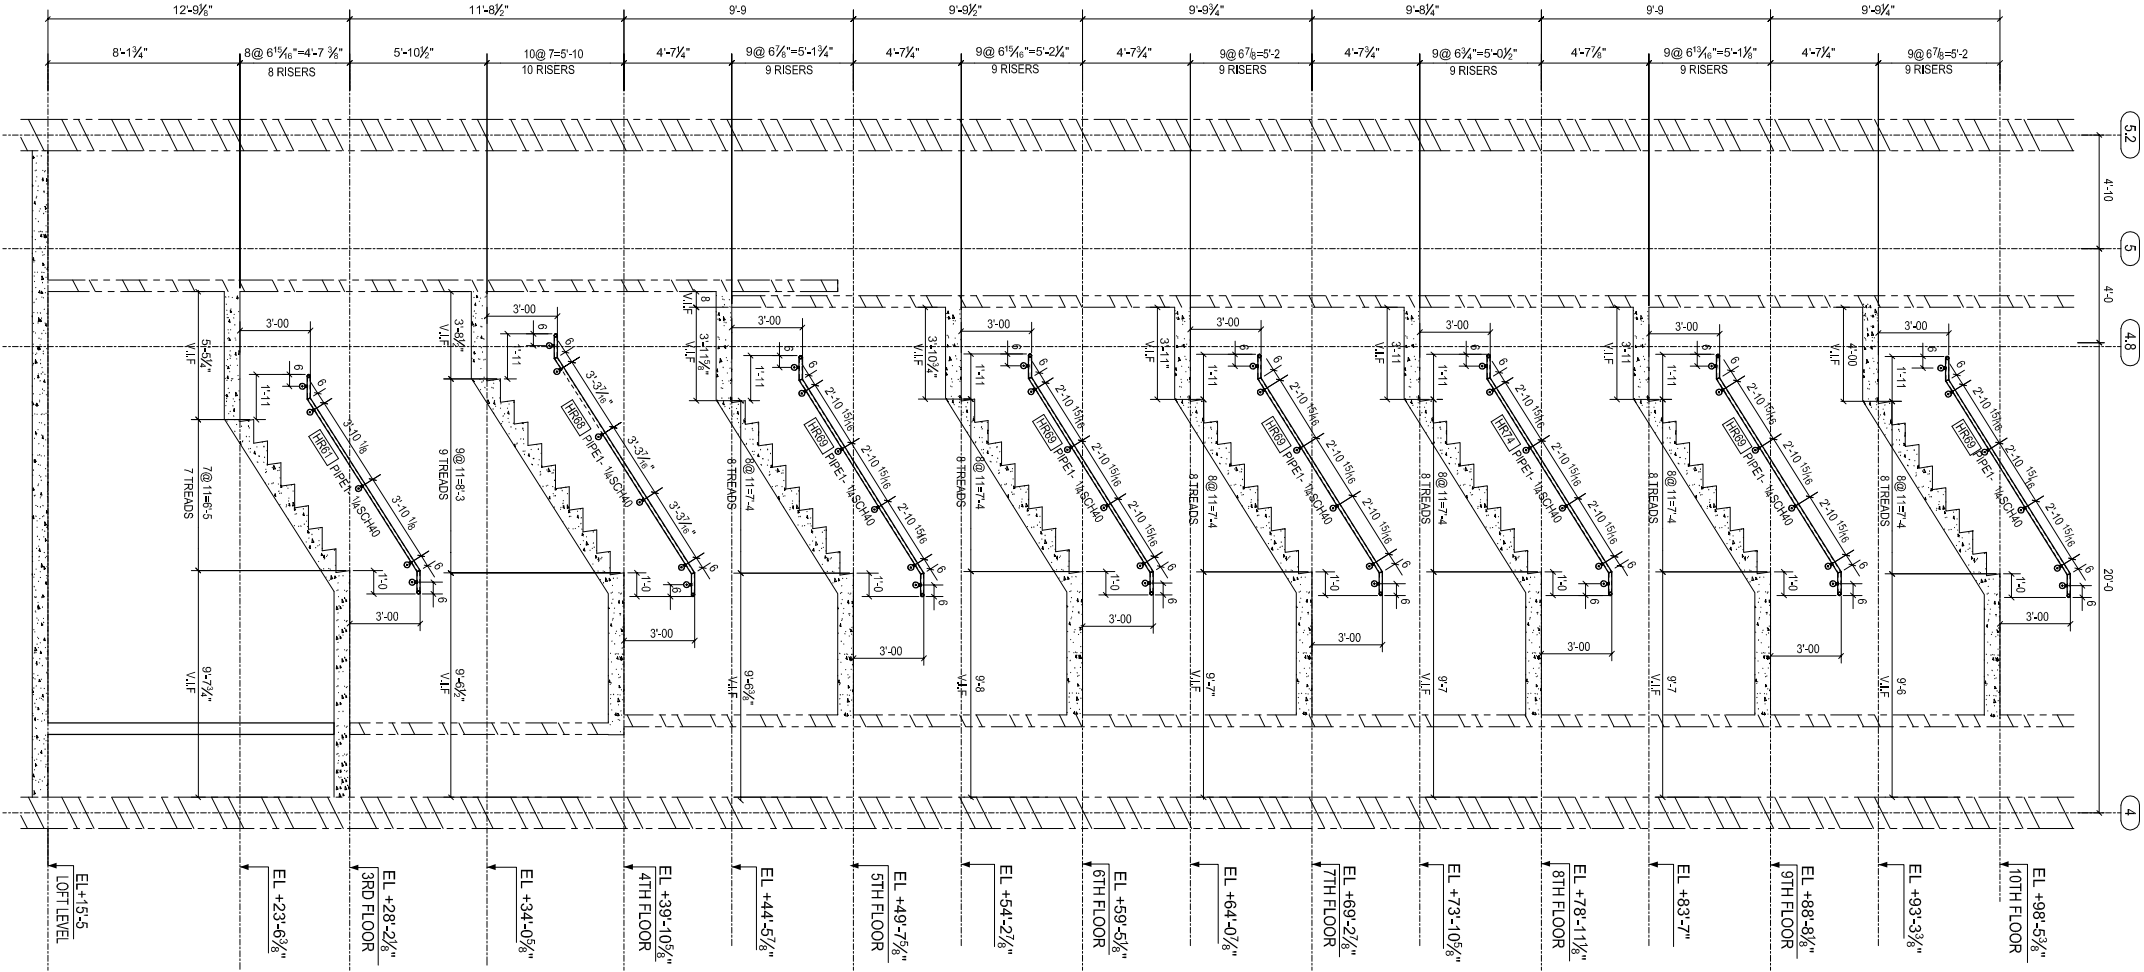

SECTION
S2 / SCALE: 1/4\"=1'-0"

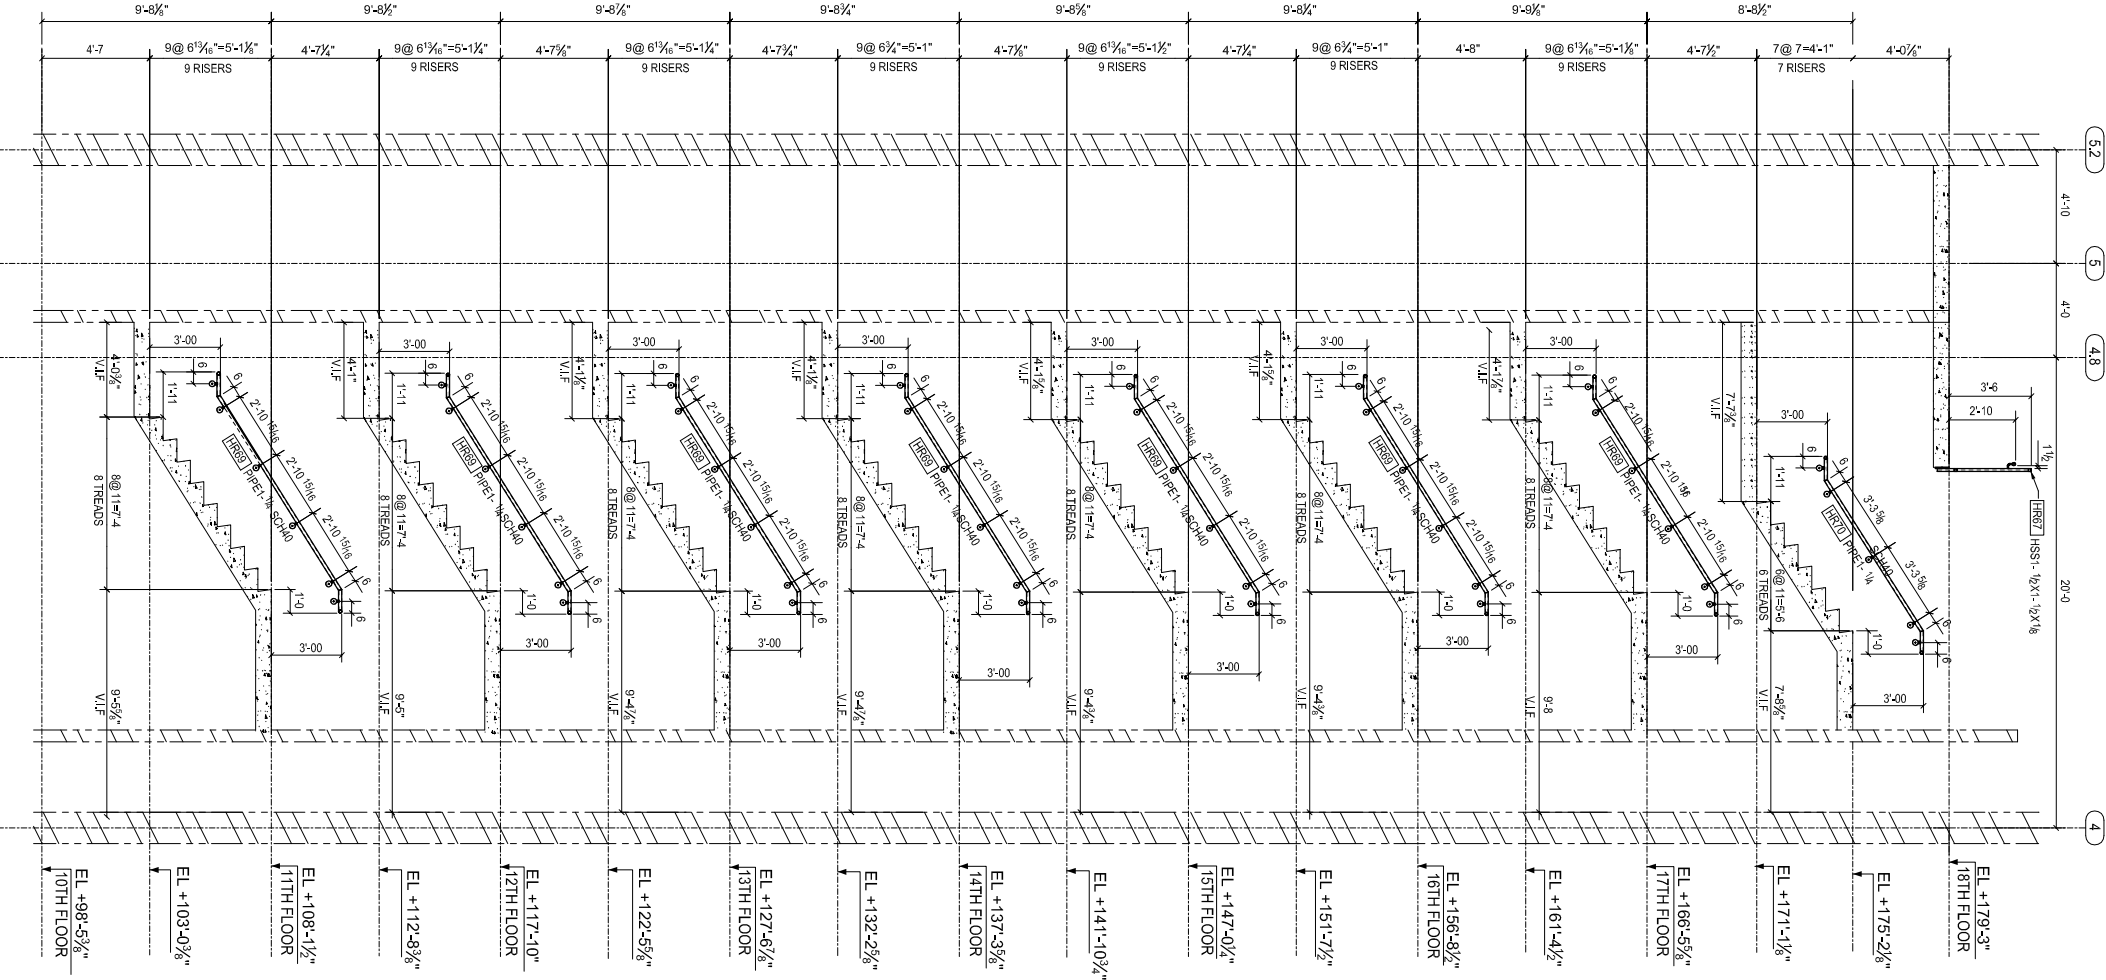

MATCH LINE 1-1

GENERAL NOTES

0	AS BUILT	DESCRIPTION			
REV.		GENERAL NOTES	DATE	DWN	CHK
MATERIAL: -					
HOLES: 3/4 DIA. UN		CONCRETE: ASTM A635		ELECTRICAL: E70XX UN	
SURFACE PREP: SSPC-SP10					
AND PAINT: ONE COAT OF SHOP PRIMER U.N.O. (CHEMULD Series 135)					
DESCRIPTION: STAR-2 SECTIONS					
PROJECT NAME: 625 West Division Street					
LOCATION: CHICAGO, ILLINOIS					
DRAWN BY:		CHECKED BY:		DATE	
DATE:		SCALE:		DATE	